

## Addendum

Addendum Number: 1

Addendum Date: 8/23/21

Written To: Max Kasper

Project Name: Swampscott Middle School Hydronics Upgrades

CES Project Number: 2021333.00

Written By: David Hillburn, PE

The work shall be carried out in accordance with the following supplemental instructions and in accordance with the Contract Documents.

Description:

MEP-0: ADD ET-2 to expansion tank schedule

**MEP-1: ADD** ET-2 to new work floor plan. ADD existing boiler panel as power for new circuit on floor plan and keynote 1.

**MEP-5: ADD** ET-2 and piping to hot water diagram.

Attachments: MEP-0

MEP-1

MEP-5

## **END OF ADDENDUM #1**

MAS/mas/Addendum.doc

Cc:

HVAC D	EMOLITION LEGEND
SYMBOL	DESCRIPTION
<b>V/////X</b> .	REMOVE EXISTING DUCTWORK/EQUIPMENT
%/////////////////////////////////////	REMOVE EXISTING PIPING/EQUIPMENT
ETR	EXISTING TO REMAIN
RE	REMOVE EXISTING
RL	RELOCATE EXISTING
NL	NEW LOCATION

PIPI	NG LEGEND
SYMBOL	DESCRIPTION
<del>} </del> HWS <del> </del>	HOT WATER SUPPLY
<b>&gt;</b> HWR <b></b> →	HOT WATER RETURN
<b>├</b> ─── <b>├</b>	GATE VALVE
<b>├</b> ── <del></del>	BALL VALVE
<b>├</b>	GLOBE VALVE
<u></u>	BUTTERFLY VALVE
<b>→</b>	CHECK VALVE
\\\\\\\\\\	UNION
\ \ \ \ \ \ \ \ \ \ \ \ \ \ \ \ \ \ \	STRAINER WITH VALVED BLOWDOWN
\ \ \ \ \ \ \ \ \ \ \ \ \ \ \ \ \ \ \	PIPE ANCHOR
<del>\</del>	PIPE DROP
· · · · · · · · · · · · · · · · · · ·	PIPE RISE

TEMPERA	ATURE CONTROL LEGEND
SYMBOLS	DESCRIPTION
AI	ANALOG INPUT
AO	ANALOG OUTPUT
DI	DIGITAL INPUT
DO	DIGITAL OUTPUT
A	AQUASTAT
T	TEMPERATURE SENSOR
T	THERMOSTAT
Н	RELATIVE HUMIDITY SENSOR
C	CARBON DIOXIDE SENSOR
FM	FLOW METER
AFMS	AIR FLOW MEASURING STATION
CSR	CURRENT SENSING RELAY
ES	ENDSWITCH
VFD	VARIABLE FREQUENCY DRIVE
ВҮР	VFD BYPASS
DP	DIFFERENTIAL PRESSURE
DPT	DIFFERENTIAL PRESSURE TRANSMITTER
SPS	STATIC PRESSURE SENSOR
AFS	AIR FLOW SWITCH

Consulting Engineering Services, Inc.  811 Middle Street Middletown, CT 06457 Tel. (860) 632-1682 Fax. (860) 632-1768 CES #0000.00
CES #0000.00

TOWN OF SWAMPSCOTT-SWAMPSCOTT PUBLIC SCHOOLS

1 8/23/21 ADDENDUM #

SWAMPSCOTT MIDDLE SCHOOL **HOT WATER HEATING SYSTEM** UPGRADE

24 REDINGTON STREET SWAMPSCOTT, MA 01907

> **MECHANICAL** SCHEDULES, NOTES, AND **SYMBOLS**

DATE:	8/11/21
PROJECT NO:	2021333.00
DRAWN:	DJH
CHECKED:	EJR
ISSUED FOR:	BIDDING
<b>REVISIONS:</b>	<b>Current Revision</b>


MEP-0

GLYCOL MAKE-UP UNIT				UNIT SCHE	DULE			
SYMBOL	MANUFACTURER/ MODEL NUMBER	SYSTEM SERVED	LOCATION	APPROXIMATE TANK VOLUME (GAL)	MAXIMUM DISCHARGE PRESSURE (PSIG)	DIMENSIONS DIA.XH (IN)	ELECTRICAL	REMARKS
GMU-1	SKIDMORE S-100-100-2-PEFS	HW	BOILER ROOM	100	100	39Ø x 49.75	120V/1PH/ 60HZ	1-6

- SINGLE POINT POWER CONNECTION.
   TIMED MIXING LOOP.
   HIGH AND LOW LEVEL ALARMS.
   MANUAL ON/OFF PUMP OPERATION
   UL CONTROL PANEL.
   PRESSURE RELIEF VALVES.

	F				EXPANSION TANK SCHEDULE				
1	SYMBOL	MANUFACTURER/ MODEL NUMBER	TYPE	LOCATIO	ON CONFIGURATION	TANK VOLUME (GAL)	MIN. ACCEPTANCE VOLUME (GAL)	SIZE (DIA X H)	REMARKS
\ \ \ \ \ \ \ \ \ \ \ \ \ \ \ \ \ \ \	ET-1 & ET-2	TACO CA300-125	В	MECH RO	OOM VERTICAL	79	79	24x58	1-3
	TYPES:  B = BLADDER EXPANSION TANK  D = DIAPHRAGM EXPANSION TANK  BT = BUFFER TANK			ਜ	CONFIGURATION: I = HORIZONTAL I = VERTICAL (FLOOR MOUI	NTED)			

PROVIDE ALL REQUIRED TANK FITTINGS AND VALVES.
 MAXIMUM TANK PRESSURE: 100 PSI
 MINIMUM TANK PRESSURE: 15 PSI

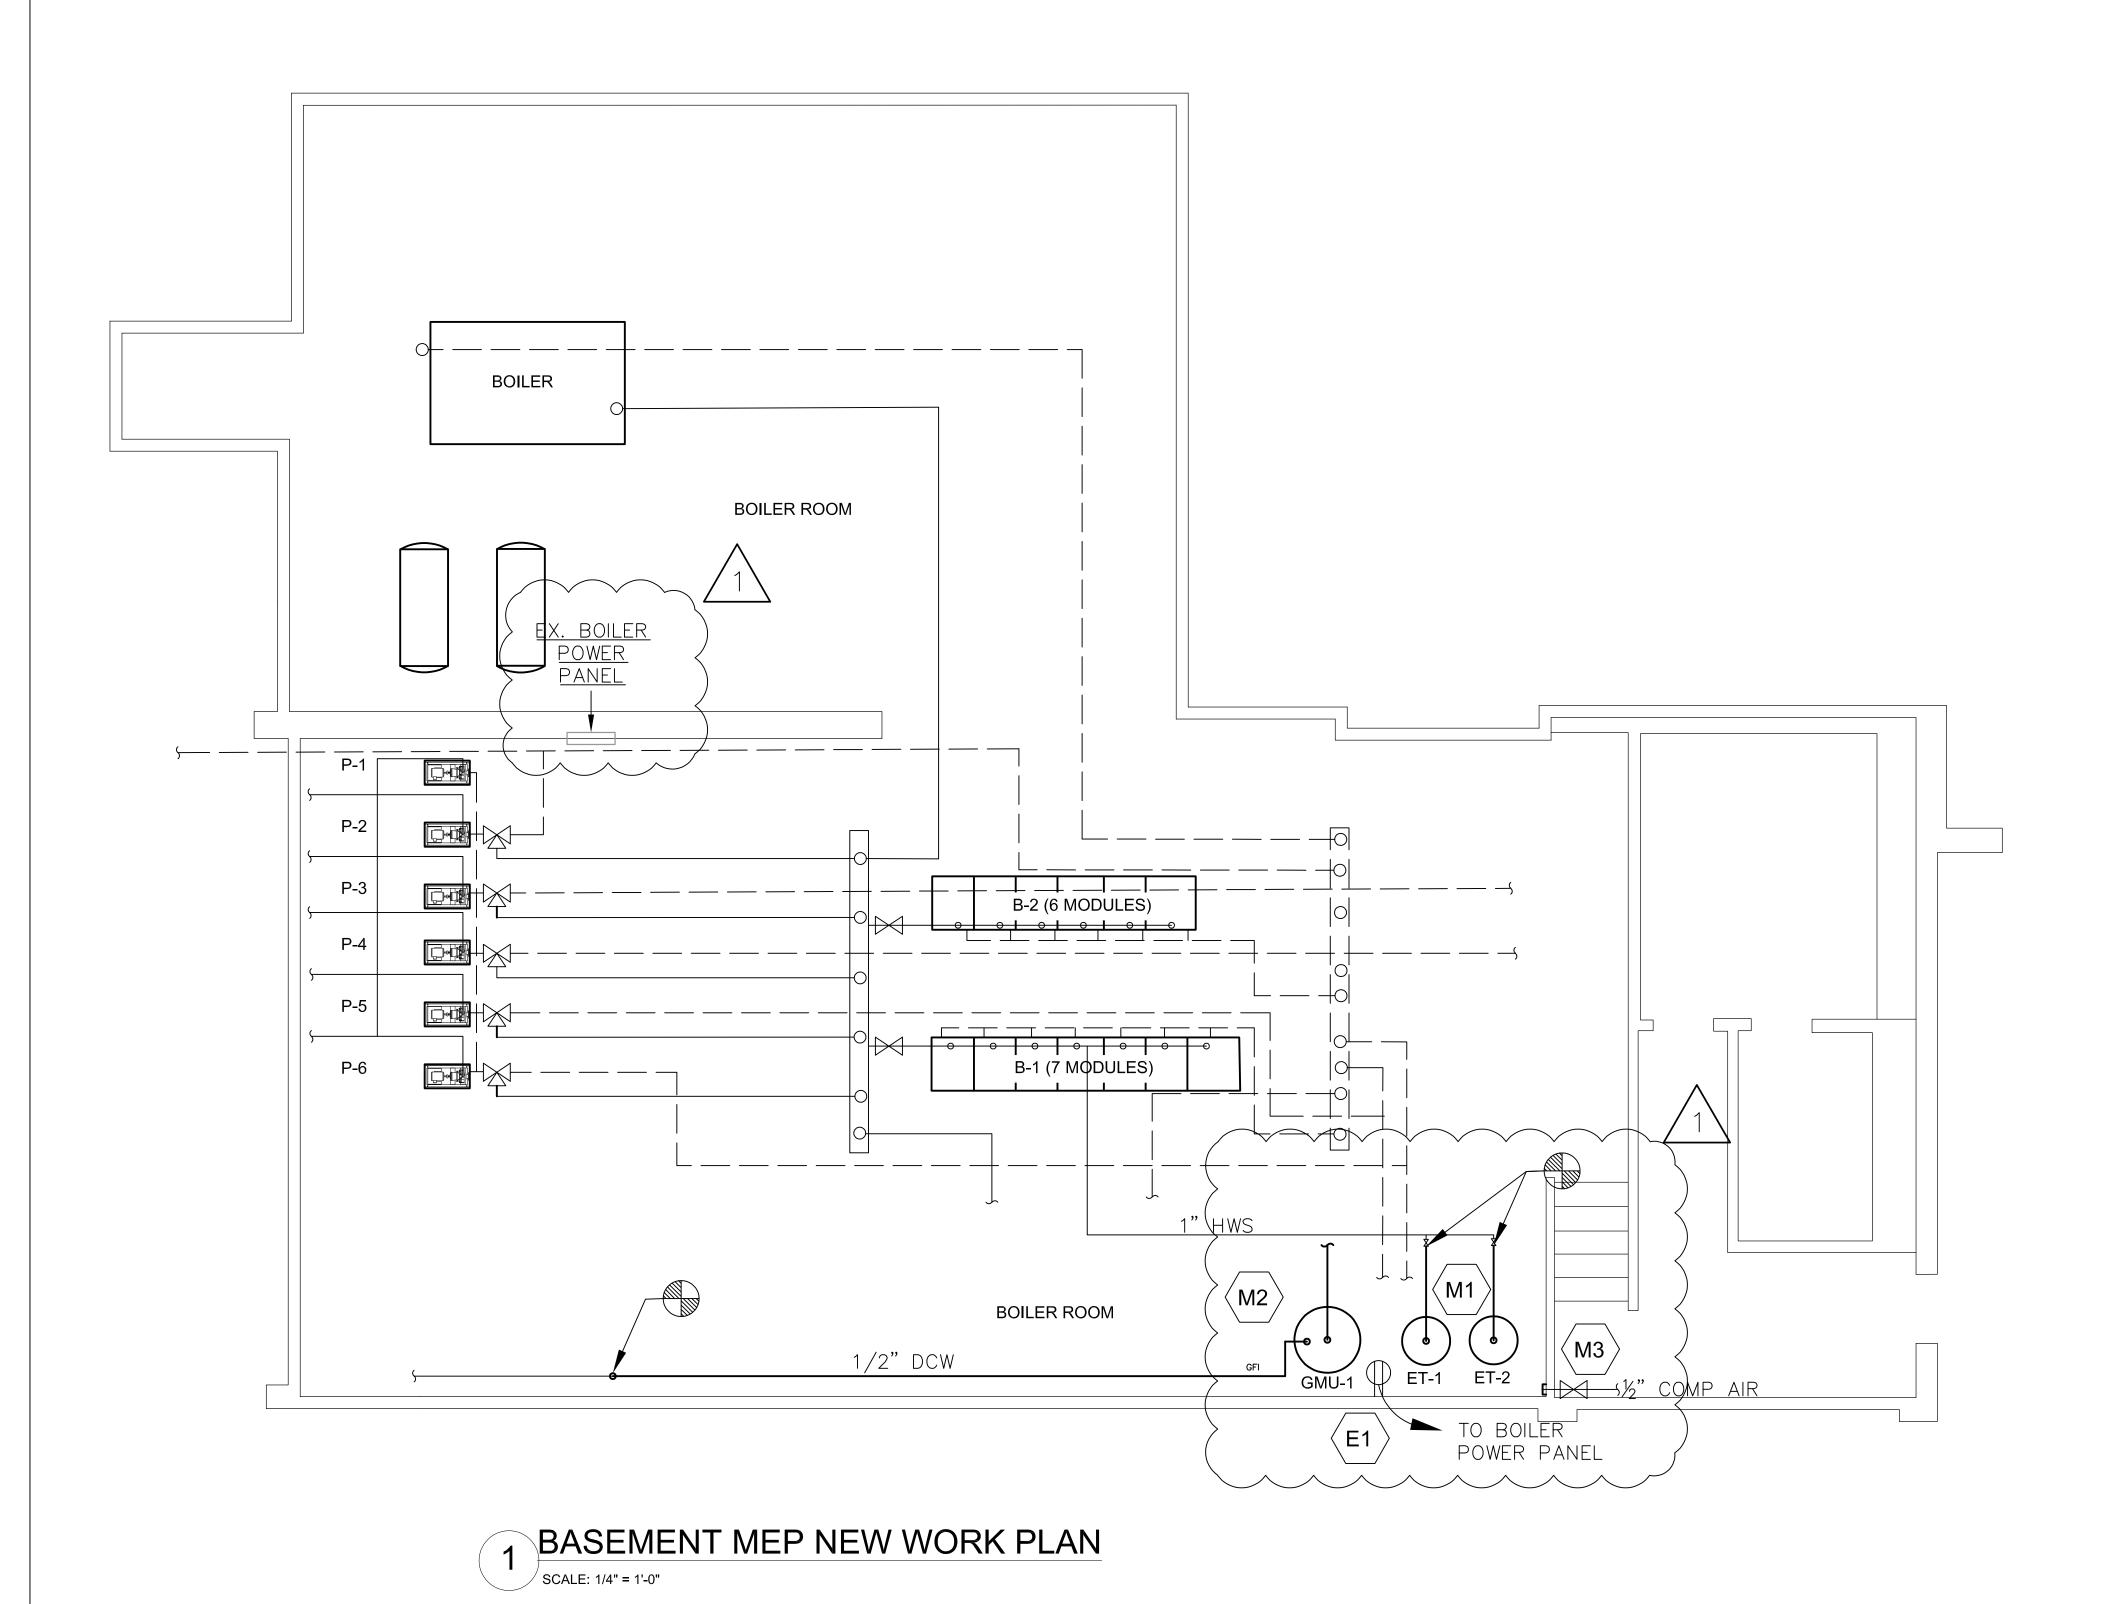

## MECHANICAL, ELECTRICAL, AND PLUMBING NEW WORK KEY NOTES PROVIDE NEW EXPANSION TANKS AND CONNECT TO EXISTING HOT WATER HEATING SYSTEM PER DETAIL 1 SHT MEP-5.

- PROVIDE NEW GLYCOL MAKE-UP UNIT AND CONNECT TO EXISTING HOT WATER SYSTEM PER DETAIL 2 SHT MEP-5.

- LOCATE OUTLET WITHIN 6FT FROM UNIT. USE 2#12, #12G, 3/4"C FROM NEW 15A/1P CIRCUIT BREAKER TO EXISTING GE A SERIES AF31S BOILER POWER PANEL.



811 Middle Street Middletown, CT 06457 Tel. (860) 632-1682 Fax. (860) 632-1768 CES #0000.00

TOWN OF SWAMPSCOTT-SWAMPSCOTT PUBLIC

		REVISIONS
NO.	DATE	DESCRIPTION
1	8/23/21	ADDENDUM #1

SCHOOLS


SWAMPSCOTT MIDDLE SCHOOL **HOT WATER HEATING SYSTEM UPGRADE** 


24 REDINGTON STREET SWAMPSCOTT, MA 01907

> **MECHANICAL PIPING BASEMENT**

8/11/21 PROJECT NO: 2021333.00 DRAWN: DJH
CHECKED: EJR
ISSUED FOR: BIDDING
REVISIONS: Current Revision

MEP-1

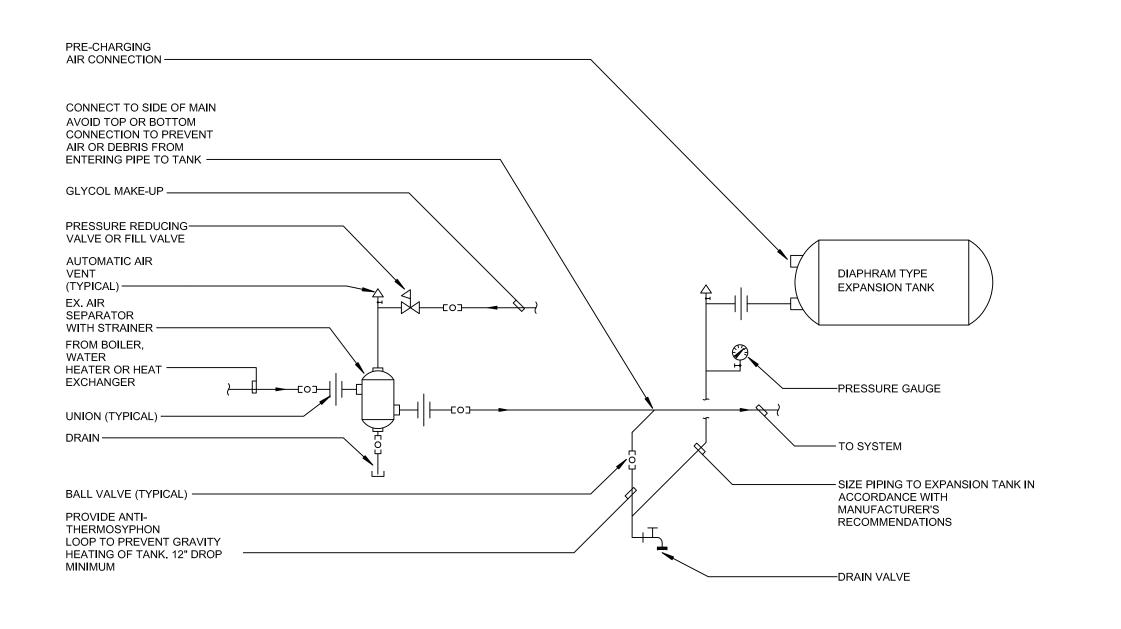


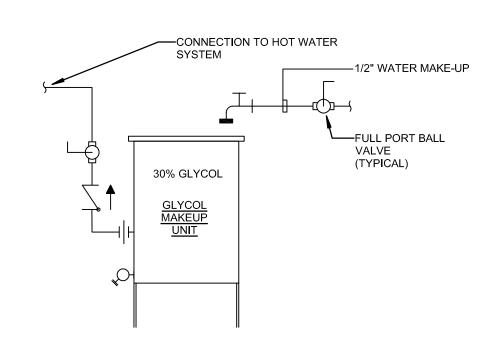

1 EXPANSION TANK PIPING DETAIL

N.T.S.

2 GLYCOL MAKEUP UNIT PIPING DETAIL
N.T.S.

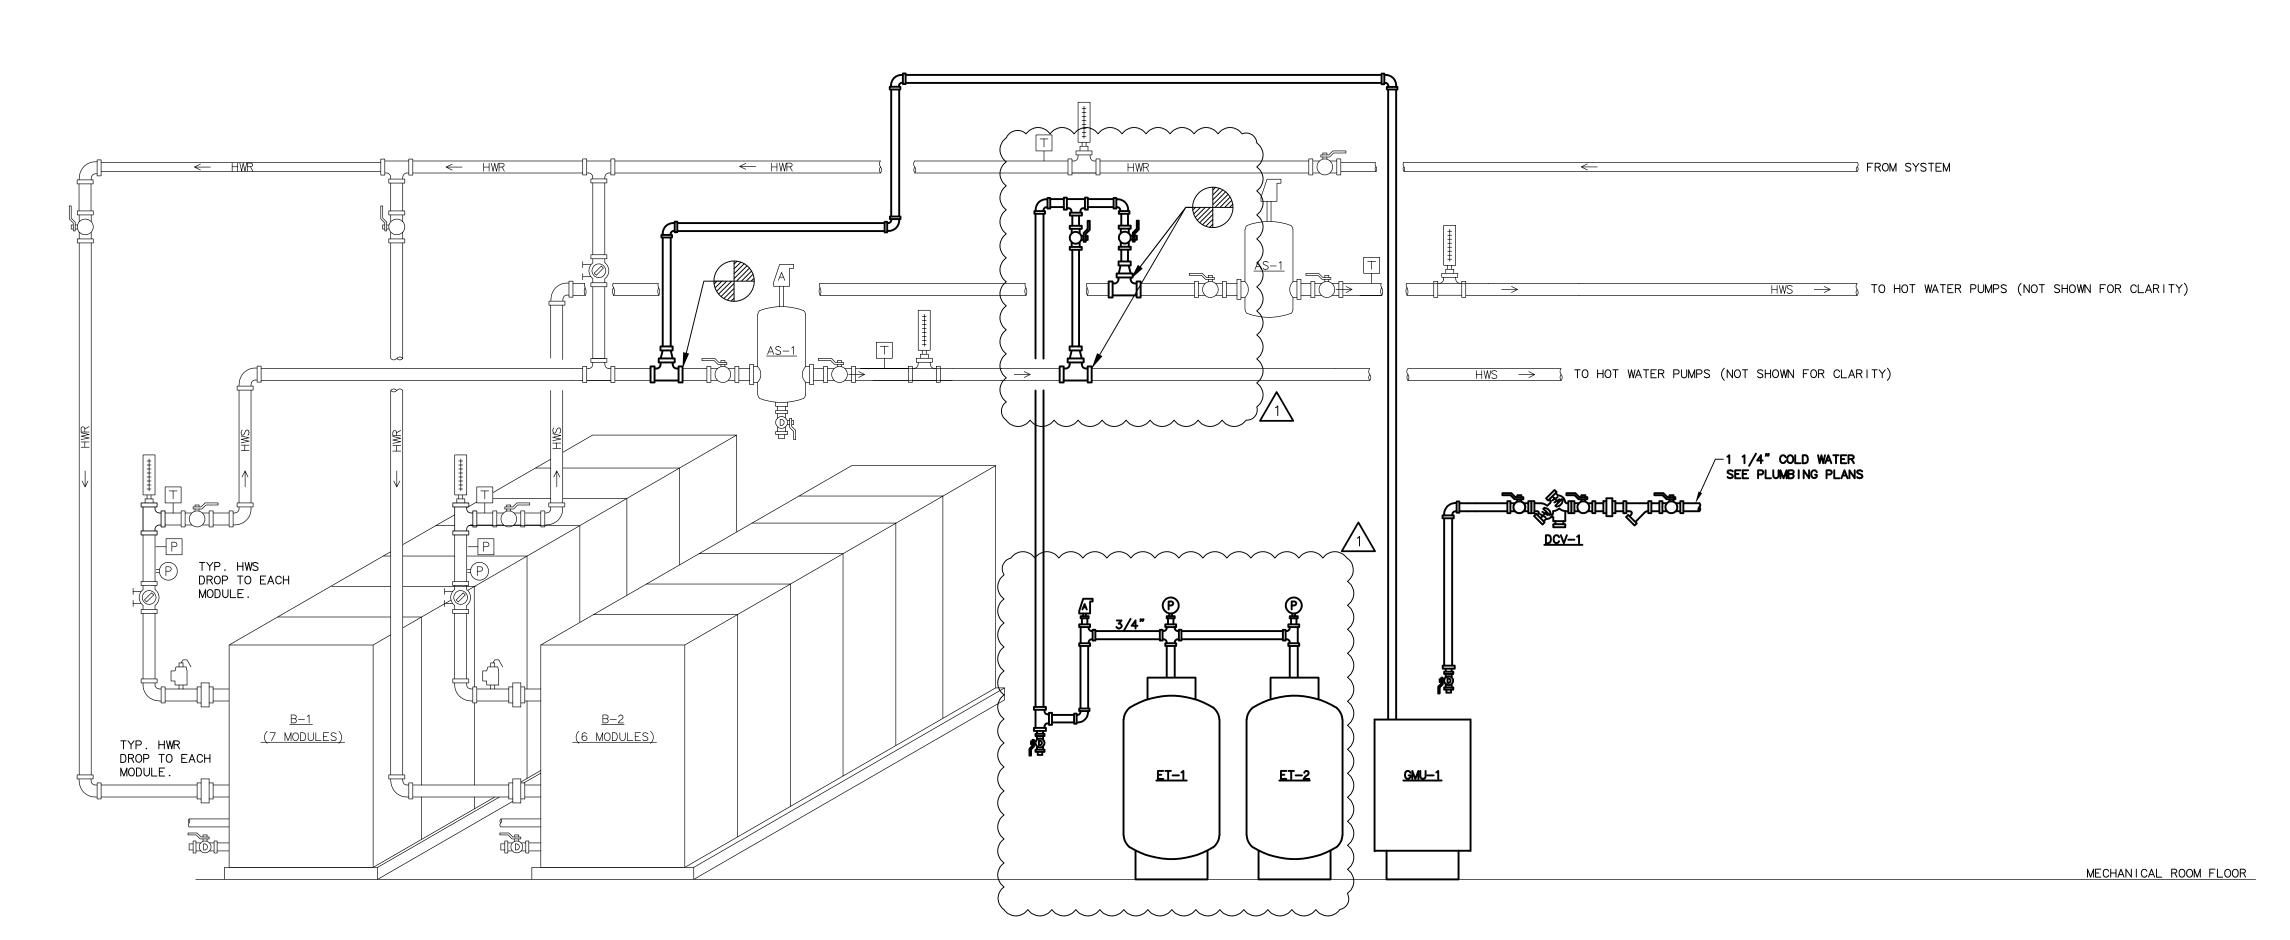

3 HOT WATER BOILER DIAGRAM - NEW WORK

N.T.S.



| 811 Middle Street Middletown, CT 06457 Tel. (860) 632-1682 Fax. (860) 632-1768 CES #0000.00

TOWN OF SWAMPSCOTT-SWAMPSCOTT PUBLIC SCHOOLS

	REVISIONS					
NO.	DATE	DESCRIPTION				
1	8/23/21	ADDENDUM #1				

SWAMPSCOTT MIDDLE SCHOOL HOT WATER HEATING SYSTEM UPGRADE

24 REDINGTON STREET SWAMPSCOTT, MA 01907

MECHANICAL DETAILS AND DIAGRAM

DATE: 8/11/21
PROJECT NO: 2021333.00
DRAWN: DJH
CHECKED: EJR
ISSUED FOR: BIDDING
REVISIONS: Current Revision

SHEET

MEP-5